
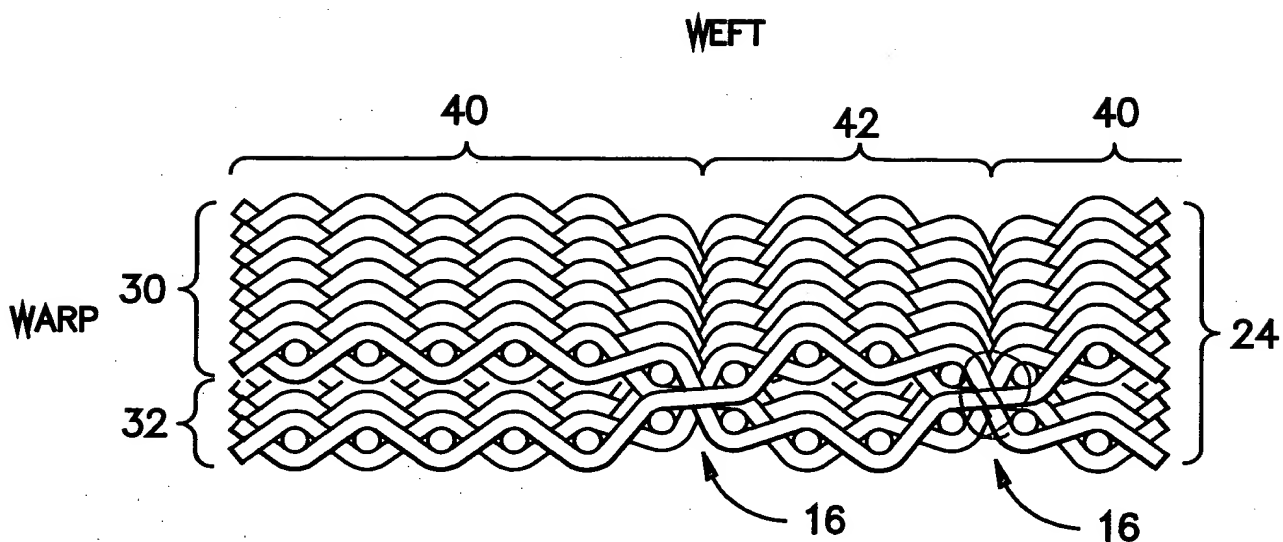


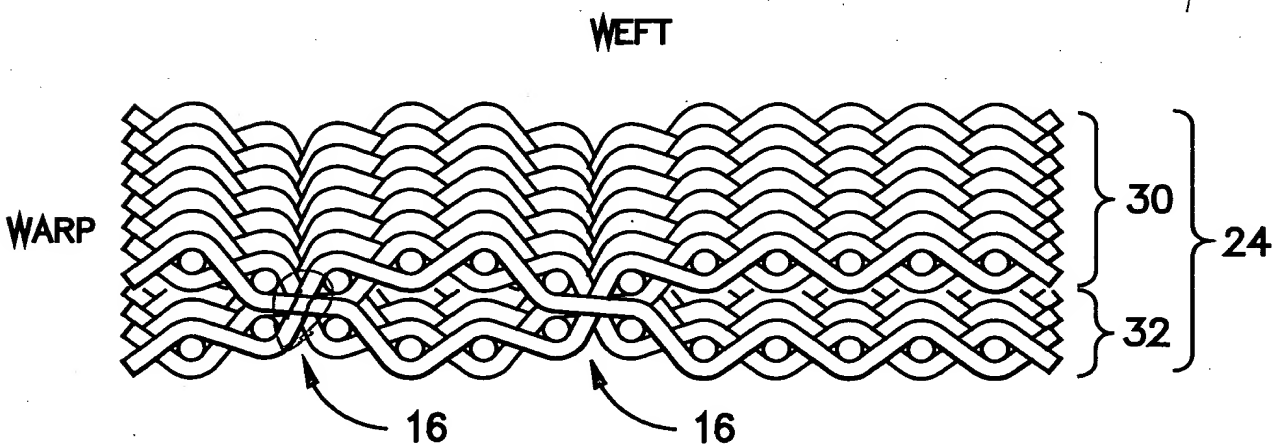

REDLINED



*FIG. -5-*



*FIG. -6-*